


100'

THIS DRAWING IS A COPYRIGHT. IT IS NOT TO BE REPRODUCED, COPIED, HANDED OVER TO A THIRD PARTY OR USED FOR ANY OTHER PURPOSE OTHER THAN FOR THE PROJECT INVOLVED.

*ALL DRAWINGS AND DIMENSIONS ARE IN FT

200'

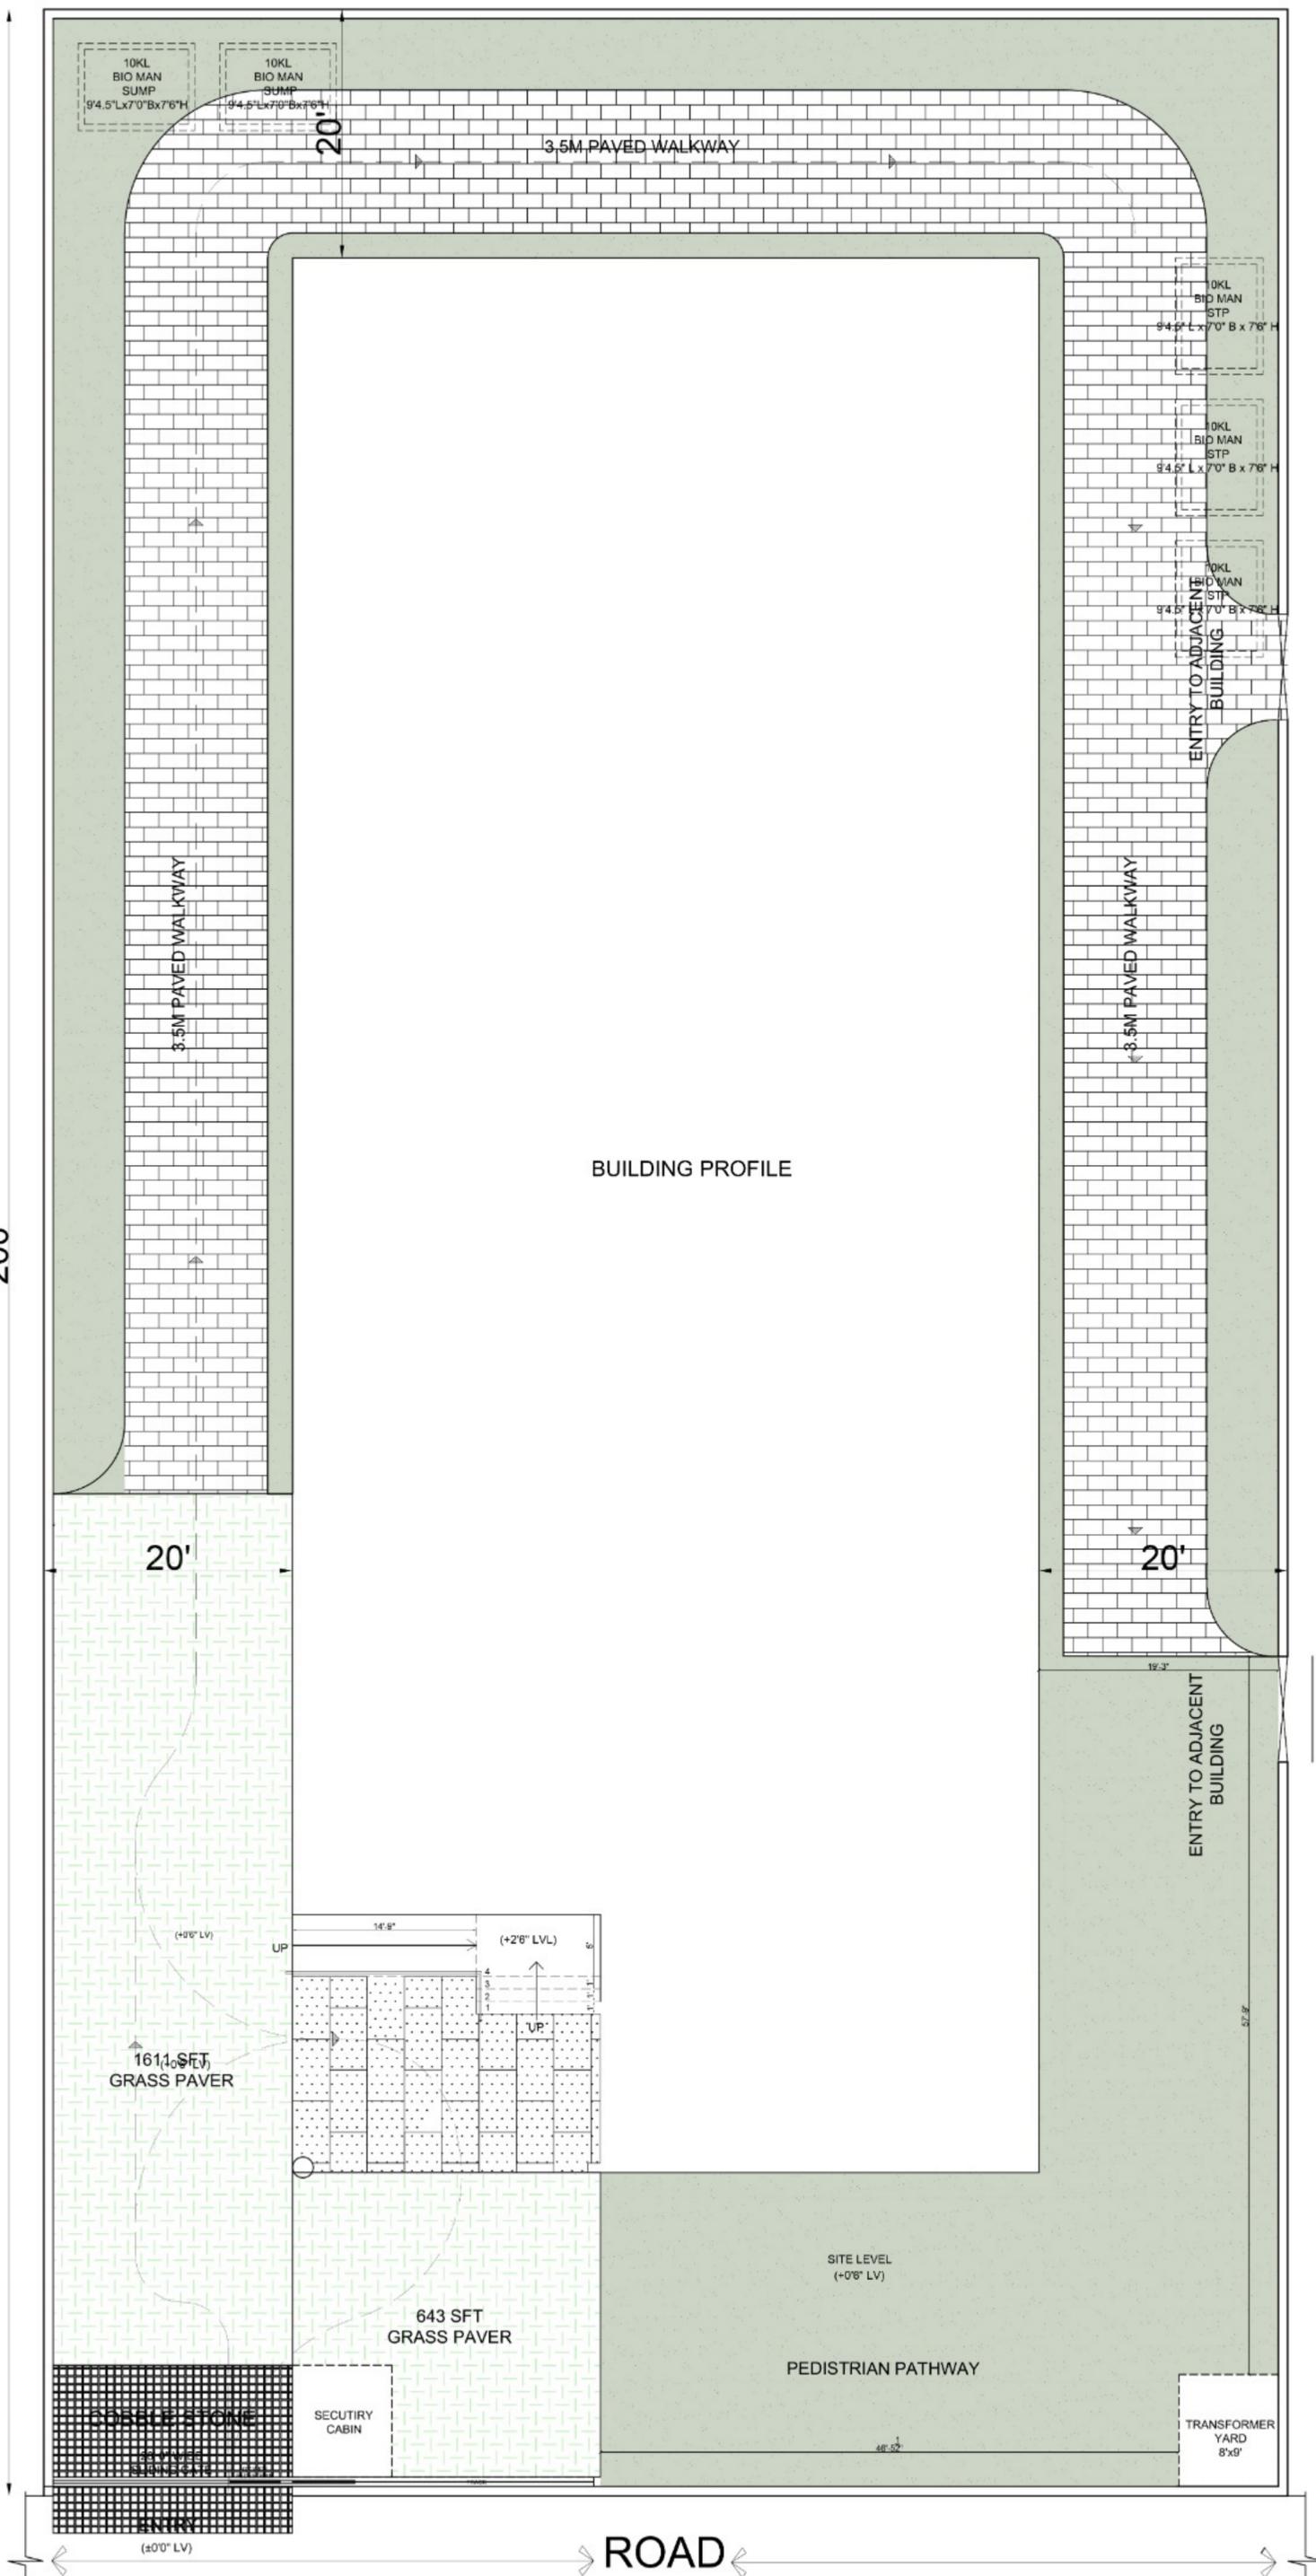

[Handwritten Signature]

PRINCIPAL
Hindustan College
(A Unit of Hindustan Educational and Charitable Trust)
No. 27/F, 3rd Stage, Rajarajeshwari Temple Road,
JP Nagar, Mysore-570 008

[Handwritten Signature]

SPECIAL OFFICER
HINDUSTAN COLLEGE
A UNIT OF HINDUSTAN EDUCATIONAL
AND CHARITABLE TRUST
No. 27/F, 3RD STAGE, INDUSTRIAL SUBURB,
J.P. NAGAR, MYSORE-570 008

AS-BUILT
DRAWINGS

[Handwritten Signature]

RAMAKRISHNAN D, M.Arch
REGISTERED ARCHITECT
No. CA/2005/35832
Flat No: 5E, Ramaniyam PUSHKAR
Phase 1, ECR Link Road,
Sholinganallur, Chennai-600 119.

REASON OF ISSUE


ARCHITECTS
S7 STUDIO 7 ARCHITECTS
PP-3, Janani Shrinilayam, Phase- 1,
Semmencheri, OMR, Chennai- 600119

CLIENT
HINDUSTAN GROUP

PROJECT
HINDUSTAN COLLEGE, MYSORE

DRAWING TITLE	DRAWING CODE	REVISION
SITE PLAN	AR - 105	
SCALE 1:110	DRAWN BVABAN	R18
DATE 18-07-2025	CHECKED RAM	

*ALL DRAWINGS AND DIMENSIONS ARE IN FT

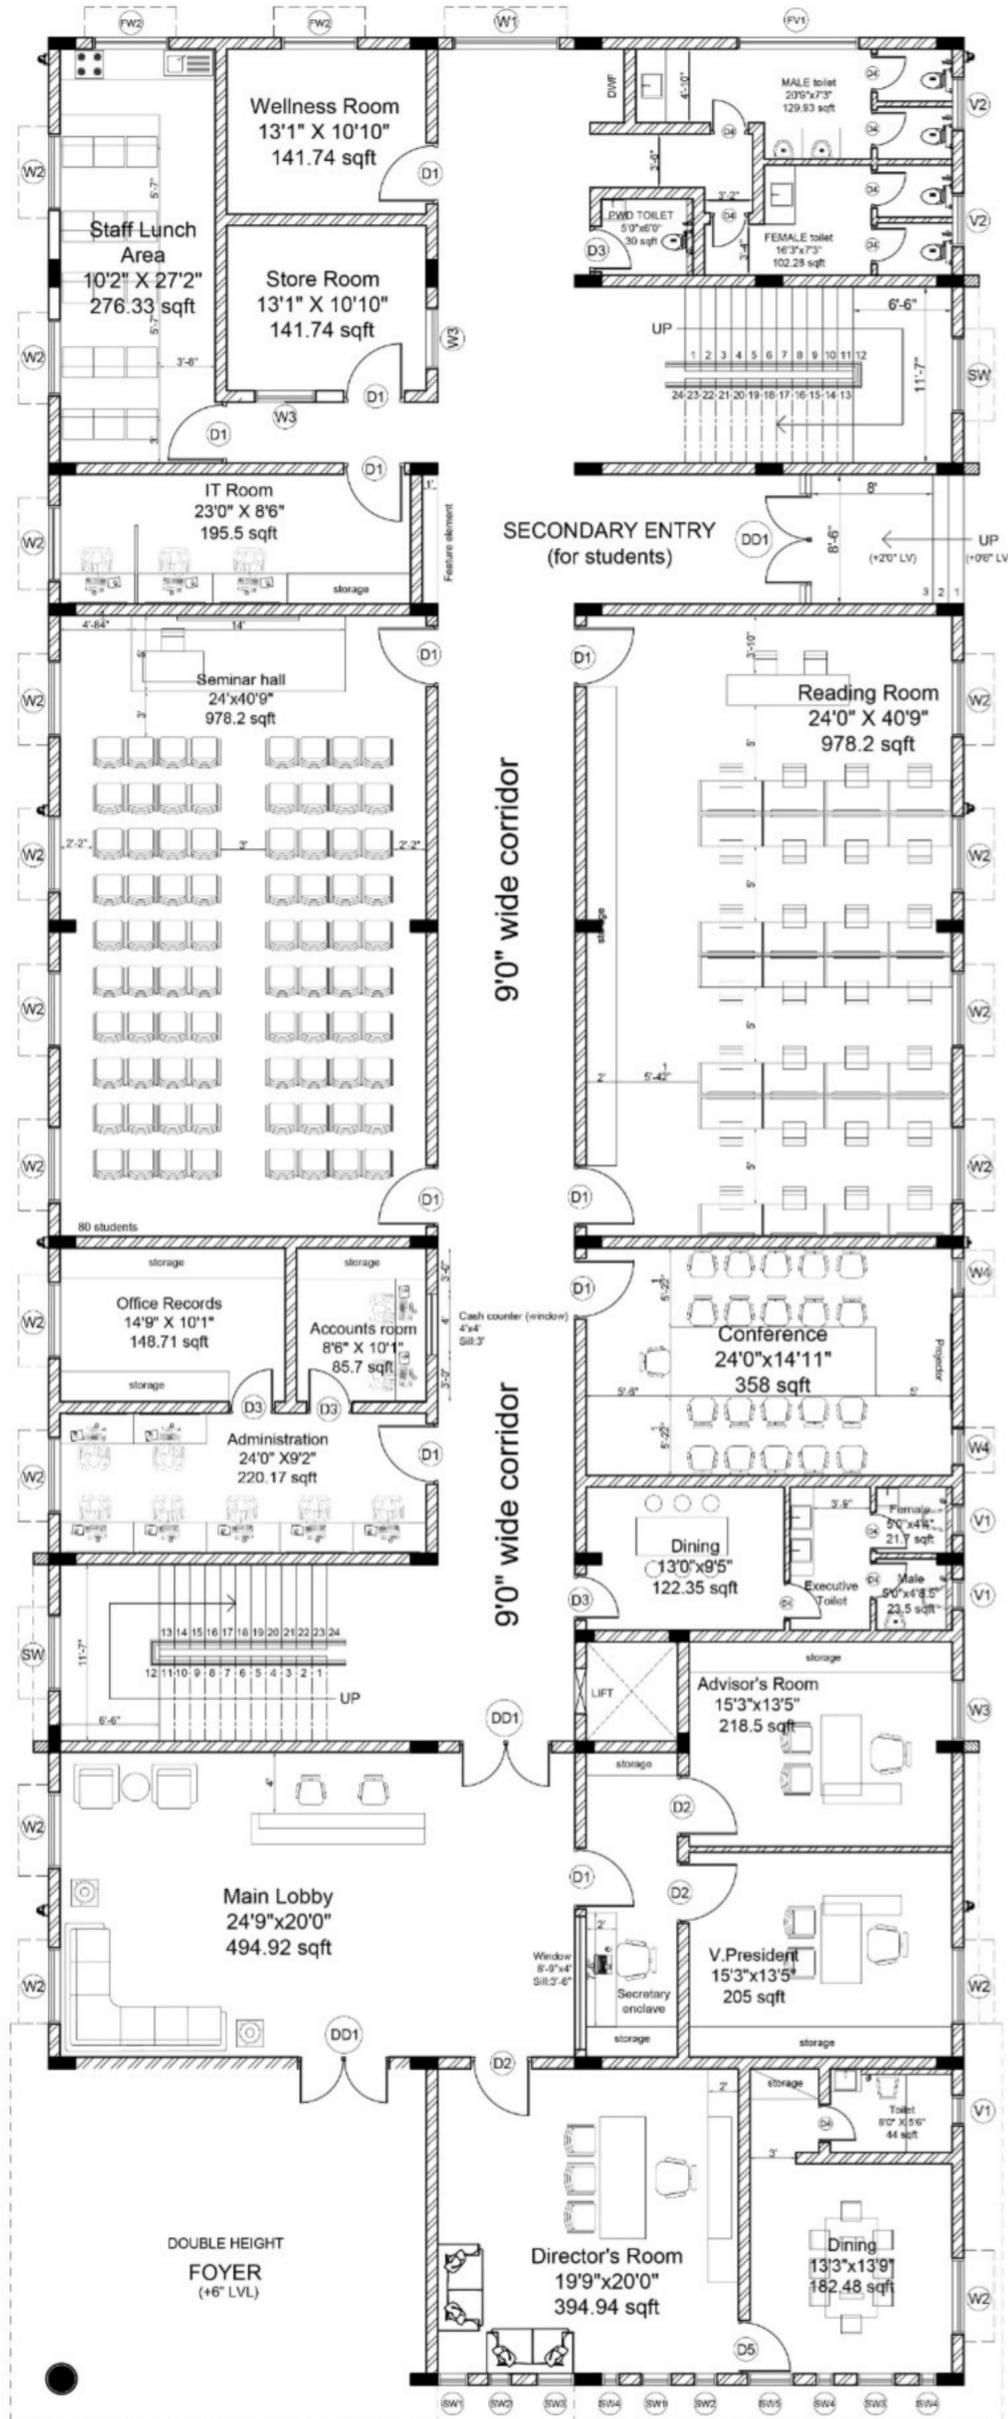

[Signature]
PRINCIPAL
 Hindustan College
 (A Unit of Hindustan Educational and Charitable Trust)
 No. 27/F, 3rd Stage, Rajarajeshwari Temple Road,
 J.P. Nagar, Mysore-570 008


[Signature]
SPECIAL OFFICER
 HINDUSTAN COLLEGE
 A UNIT OF HINDUSTAN EDUCATIONAL
 AND CHARITABLE TRUST
 No. 27/F, 3RD STAGE, RAJARAJESHWARI TEMPLE ROAD,
 J.P. NAGAR, MYSORE-570 008

AS-BUILT
 DRAWINGS

[Signature]
RAMAKRISHNAN D, M.Arch
 REGISTERED ARCHITECT
 No. CA/2005/35832
 Flat No: 5E, Ramanyam PUSHKAR
 Phase 1, ECR Link Road,
 Sholinganallur, Chennai-600 119.

REASON OF ISSUE		
ARCHITECTS		
 STUDIO 7 ARCHITECTS PP-3, Janani Shrinilayam, Phase-1, Semmencheri, OMR, Chennai- 600119		
CLIENT		
HINDUSTAN GROUP		
PROJECT		
HINDUSTAN COLLEGE, MYSORE		
DRAWING TITLE	DRAWING CODE	REVISION
GROUND FLOOR PLAN	AR - 106	
SCALE 1:100	DRAWN BY/ASAN	R17
DATE 19-03-2025	CHECKED BY/AM	

*ALL DRAWINGS AND DIMENSIONS ARE IN FT

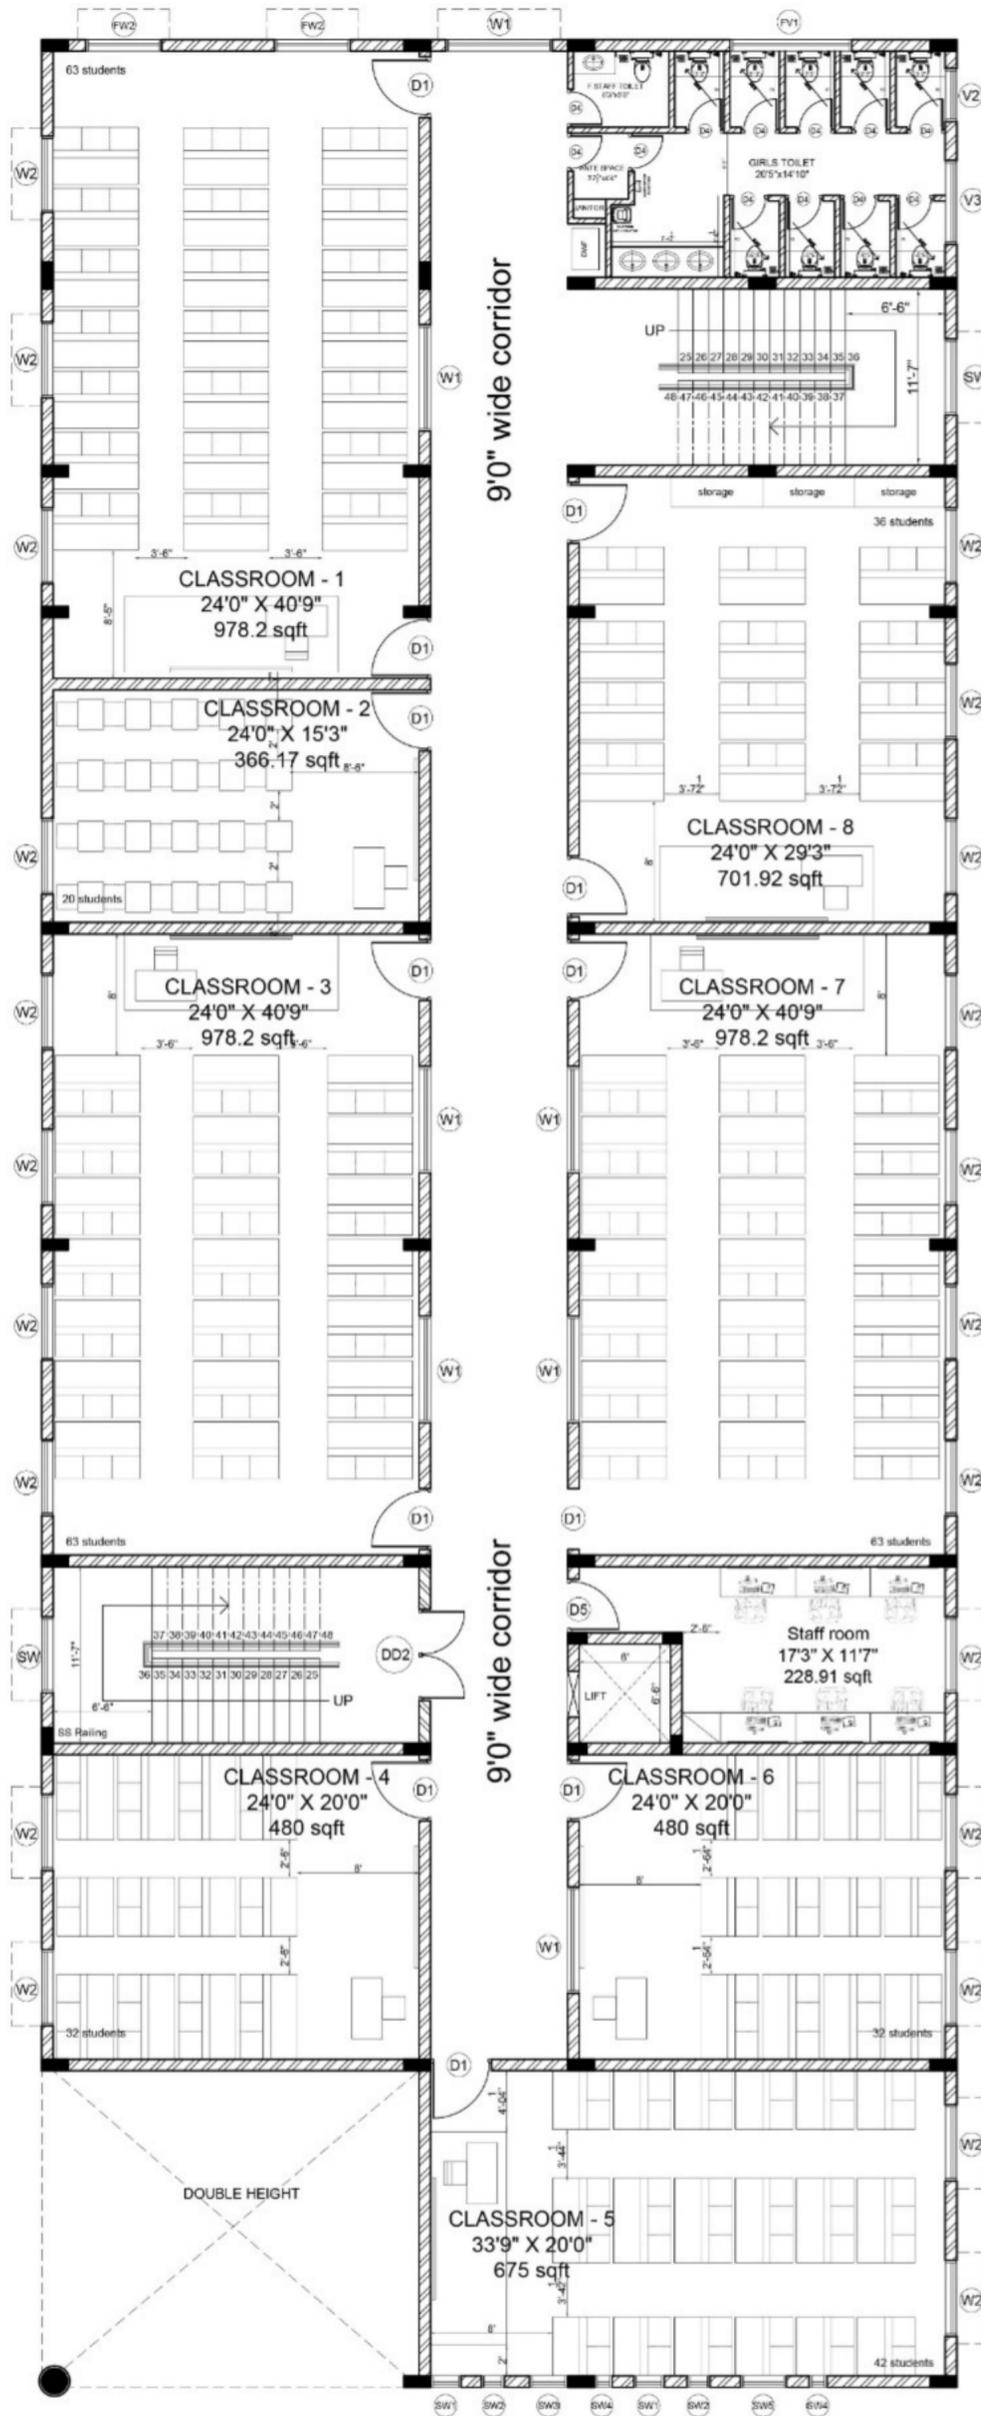

Tru
PRINCIPAL
 Hindustan College
 (A Unit of Hindustan Educational and Charitable Trust)
 No. 27/F, 3rd Stage, Rajarajeshwari Temple Road,
 J.P. Nagar, Mysore-570 008

Shu
SPECIAL OFFICER
 HINDUSTAN COLLEGE
 A UNIT OF HINDUSTAN EDUCATIONAL
 AND CHARITABLE TRUST
 No. 27/F, 3RD STAGE, INDUSTRIAL SUBURB,
 J.P. NAGAR, MYSORE-570 008

AS-BUILT
 DRAWINGS

Ramakrishnan
RAMAKRISHNAN D, M.Arch
 REGISTERED ARCHITECT
 No. CA/2005/35832
 Flat No: 5E, Ramaniyam PUSHKAR
 Phase 1, ECR Link Road,
 Sholinganallur, Chennai-600 119.

REASON OF ISSUE

ARCHITECTS


STUDIO 7 ARCHITECTS
 PP-3, Janani Shrinilayam, Phase- 1,
 Semmencheri, OMR, Chennai- 600119

CLIENT
 HINDUSTAN GROUP

PROJECT
 HINDUSTAN COLLEGE, MYSORE

DRAWING TITLE	DRAWING CODE	REVISION
FIRST FLOOR PLAN	AR - 107	
SCALE 1:100	DRAWN BVASAN	R17
DATE 19-03-2025	CHECKED RAM	

*ALL DRAWINGS AND DIMENSIONS ARE IN FT

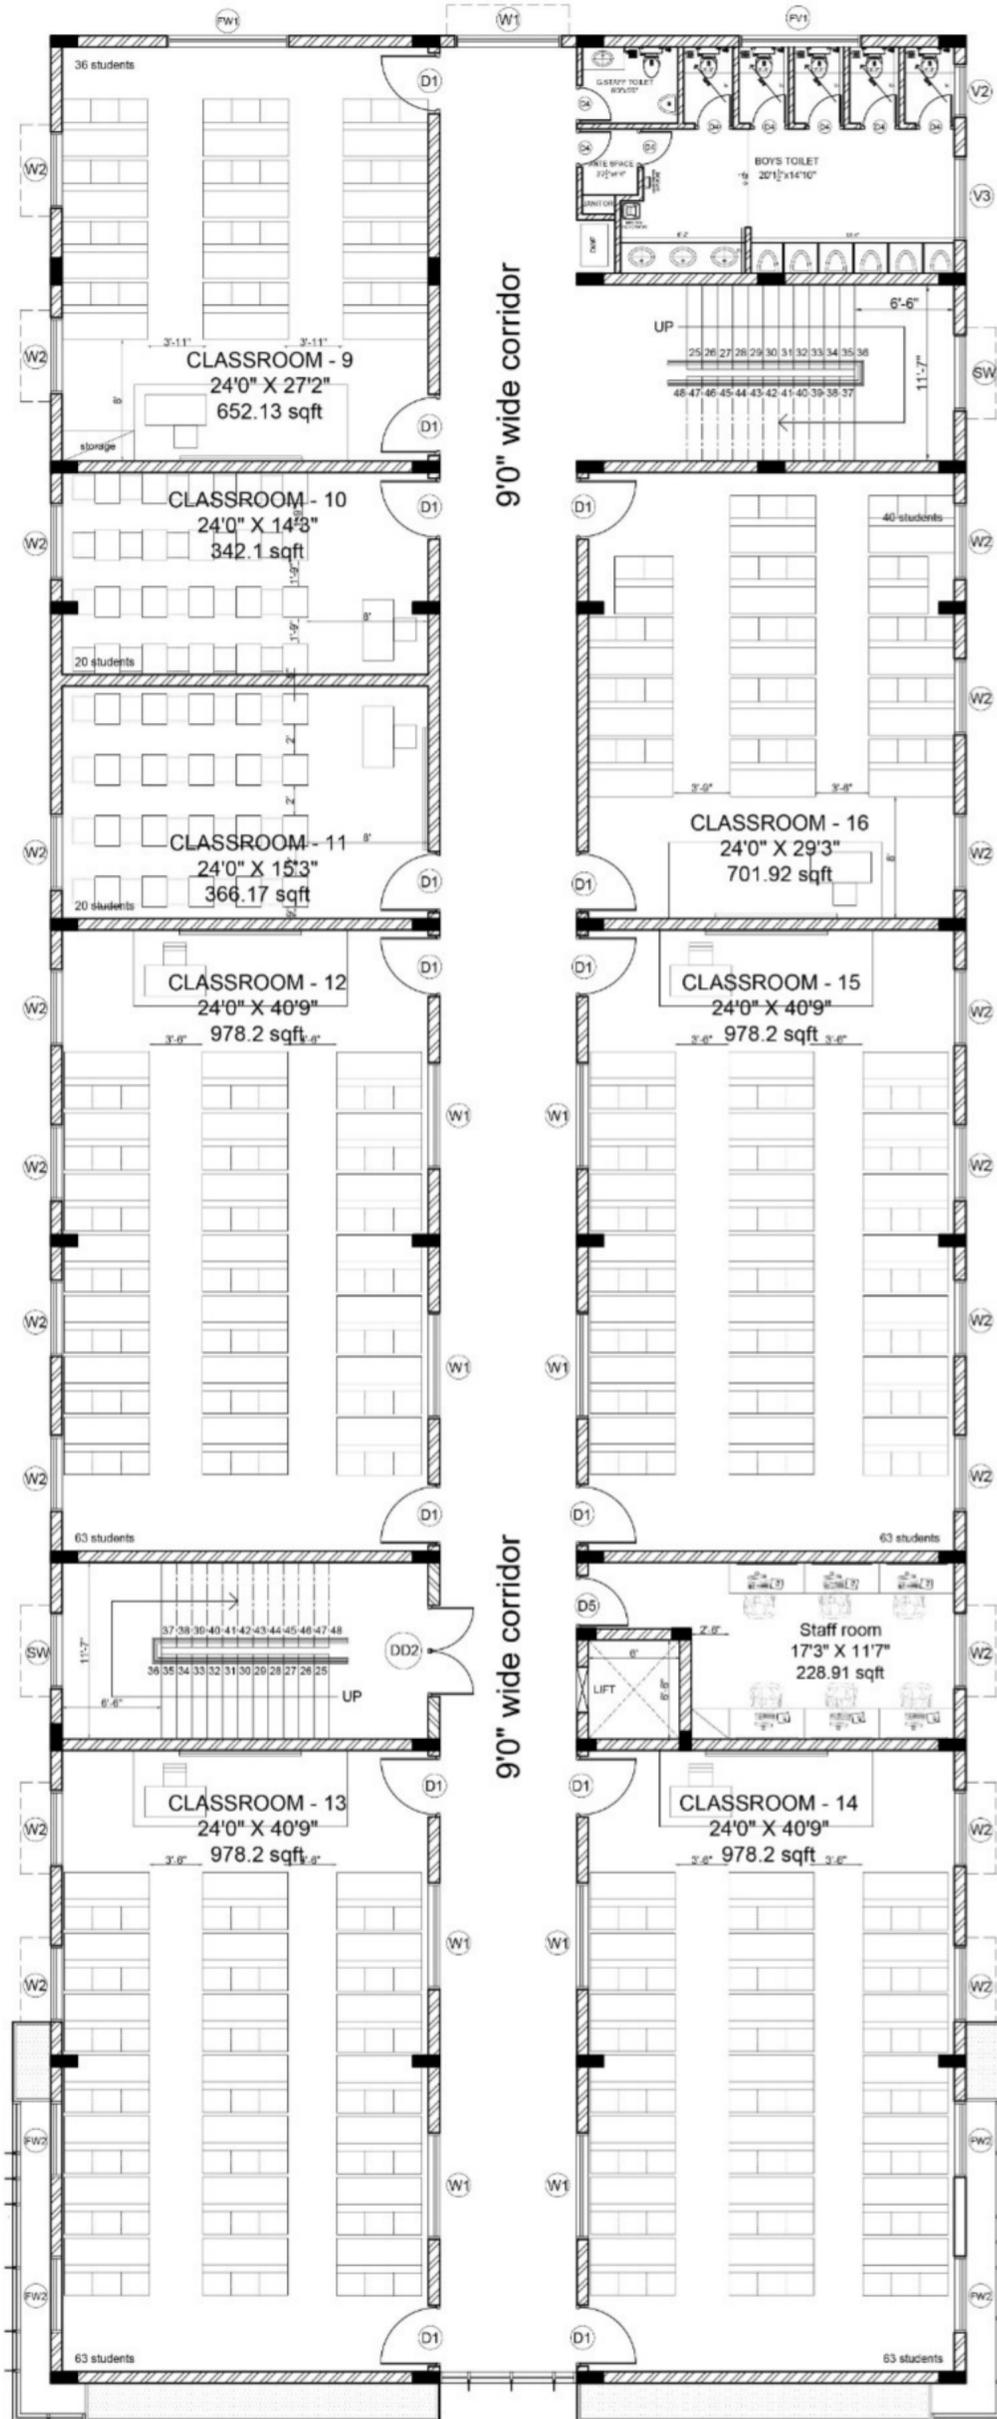

[Signature]

PRINCIPAL
Hindustan College
(A Unit of Hindustan Educational and Charitable Trust)
No. 27/F, 3rd Stage, Rajarajeshwari Temple Road,
JP Nagar, Mysore-570 008

[Signature]
SPECIAL OFFICER
HINDUSTAN COLLEGE
A UNIT OF HINDUSTAN EDUCATIONAL
AND CHARITABLE TRUST
No. 27/F, 3RD STAGE, INDUSTRIAL SUBURB,
J.P. NAGAR, MYSORE-570 008


AS-BUILT
DRAWINGS

[Signature]

RAMAKRISHNAN D, M.Arch
REGISTERED ARCHITECT
No. CA/2005/35832
Flat No: 5E, Ramaniyam PUSHKAR
Phase 1, ECR Link Road,
Sholinganallur, Chennai-600 119.

REASON OF ISSUE		
ARCHITECTS		
 STUDIO 7 ARCHITECTS PP-3, Janani Shrinilayam, Phase- 1, Semmencheri, OMR, Chennai- 600119		
CLIENT		
HINDUSTAN GROUP		
PROJECT		
HINDUSTAN COLLEGE, MYSORE		
DRAWING TITLE	DRAWING CODE	REVISION
SECOND FLOOR PLAN	AR - 108	
SCALE 1:100	DRAWN BVASAN	R17
DATE 19-03-2025	CHECKED RAM	

*ALL DRAWINGS AND DIMENSIONS ARE IN FT

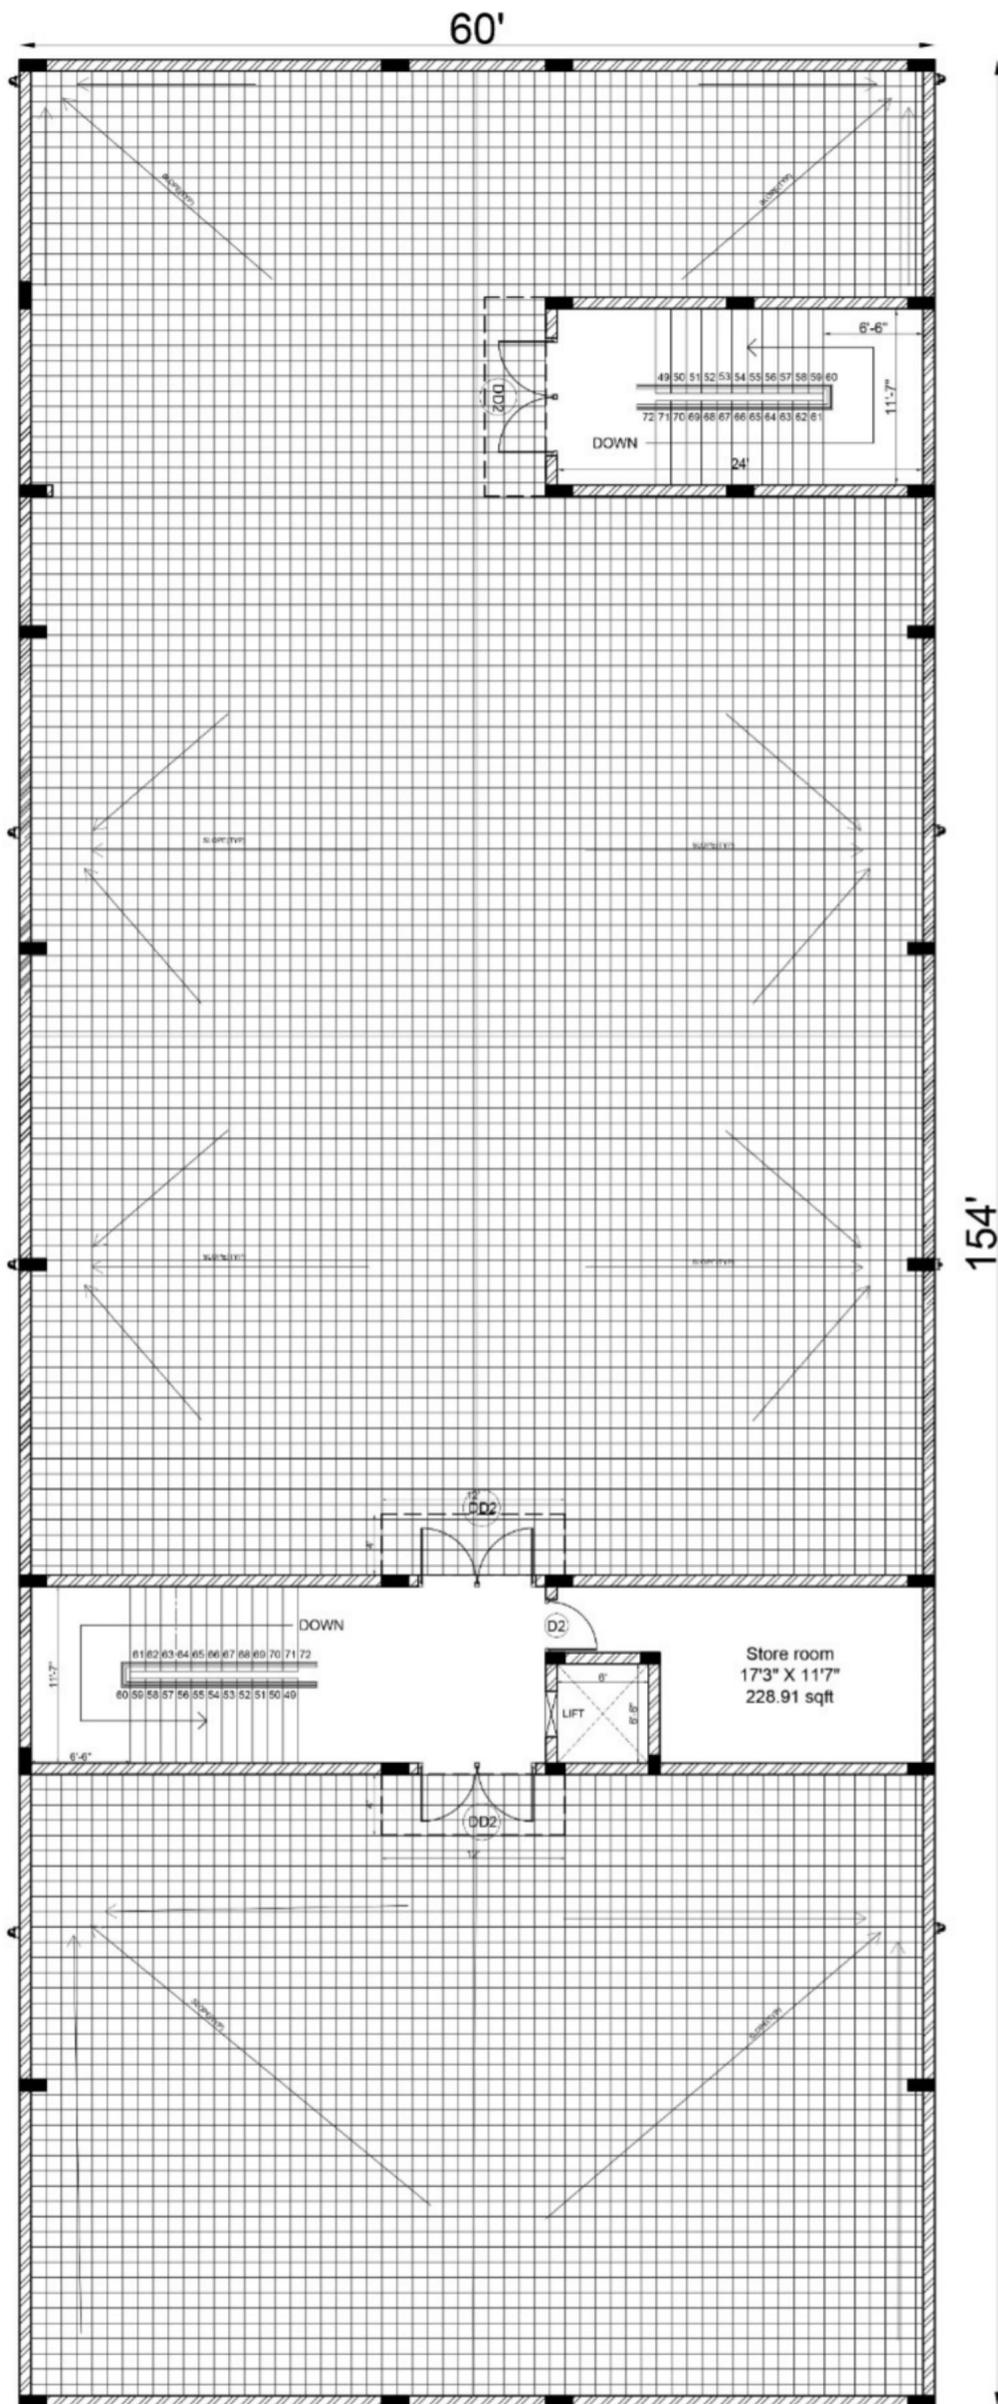

TERRACE FLOOR PLAN

[Signature]

PRINCIPAL
Hindustan College
(A Unit of Hindustan Educational and Charitable Trust)
No. 27/F, 3rd Stage, Rajarajeswari Temple Road,
JP Nagar, Mysore-570 008

[Signature]
SPECIAL OFFICER
HINDUSTAN COLLEGE
A UNIT OF HINDUSTAN EDUCATIONAL
AND CHARITABLE TRUST
No. 27/F, 3RD STAGE, INDUSTRIAL SUBURB,
J.P. NAGAR, MYSORE-570 008

AS-BUILT
DRAWINGS

[Signature]

RAMAKRISHNAN D, M.Arch
REGISTERED ARCHITECT
No. CA/2005/35832
Flat No: 5E, Ramaniyam PUSHKAR
Phase 1, ECR Link Road,
Sholinganallur, Chennai-600 119.

REASON OF ISSUE

ARCHITECTS

S7 STUDIO 7 ARCHITECTS
PP-3, Janani Shrinilayam, Phase- 1,
Semmencheri, OMR, Chennai- 600119

CLIENT
HINDUSTAN GROUP

PROJECT
HINDUSTAN COLLEGE, MYSORE

DRAWING TITLE	DRAWING CODE	REVISION
TERRACE FLOOR PLAN	AR - 110	
SCALE 1:100	DRAWN BVASAN	R17
DATE 19-03-2025	CHECKED RAM	