

Tru
PRINCIPAL
 Hindustan College
 (A Unit of Hindustan Educational and Charitable Trust)
 No. 27/F, 3rd Stage, Rajarajeshwari Temple Road,
 JP Nagar, Mysore-570 088


Shu
SPECIAL OFFICER
 HINDUSTAN COLLEGE
 A UNIT OF HINDUSTAN EDUCATIONAL
 AND CHARITABLE TRUST
 No. 27/F, 3RD STAGE, INDUSTRIAL SUBURB,
 J.P. NAGAR, MYSORE-570 008

AS-BUILT
 DRAWINGS

Ramakrishnan D.
RAMAKRISHNAN D, M.Arch
 REGISTERED ARCHITECT
 No. CA/2005/35832
 Flat No: 5E, Ramanyam PUSHKAR
 Phase 1, ECR Link Road,
 Sholinganallur, Chennai-600 119.

REASON OF ISSUE		
ARCHITECTS		
 STUDIO 7 ARCHITECTS PP-3, Janani Shrinilayam, Phase - 1, Semmencheri, OMR, Chennai- 600119		
CLIENT		
HINDUSTAN GROUP		
PROJECT		
HINDUSTAN COLLEGE, MYSORE		
DRAWING TITLE	DRAWING CODE	REVISION
GROUND FLOOR PLAN	AR - 106	
SCALE 1:100	DRAWN BVASBAN	R17
DATE 19-03-2025	CHECKED RAM	

*ALL DRAWINGS AND DIMENSIONS ARE IN FT

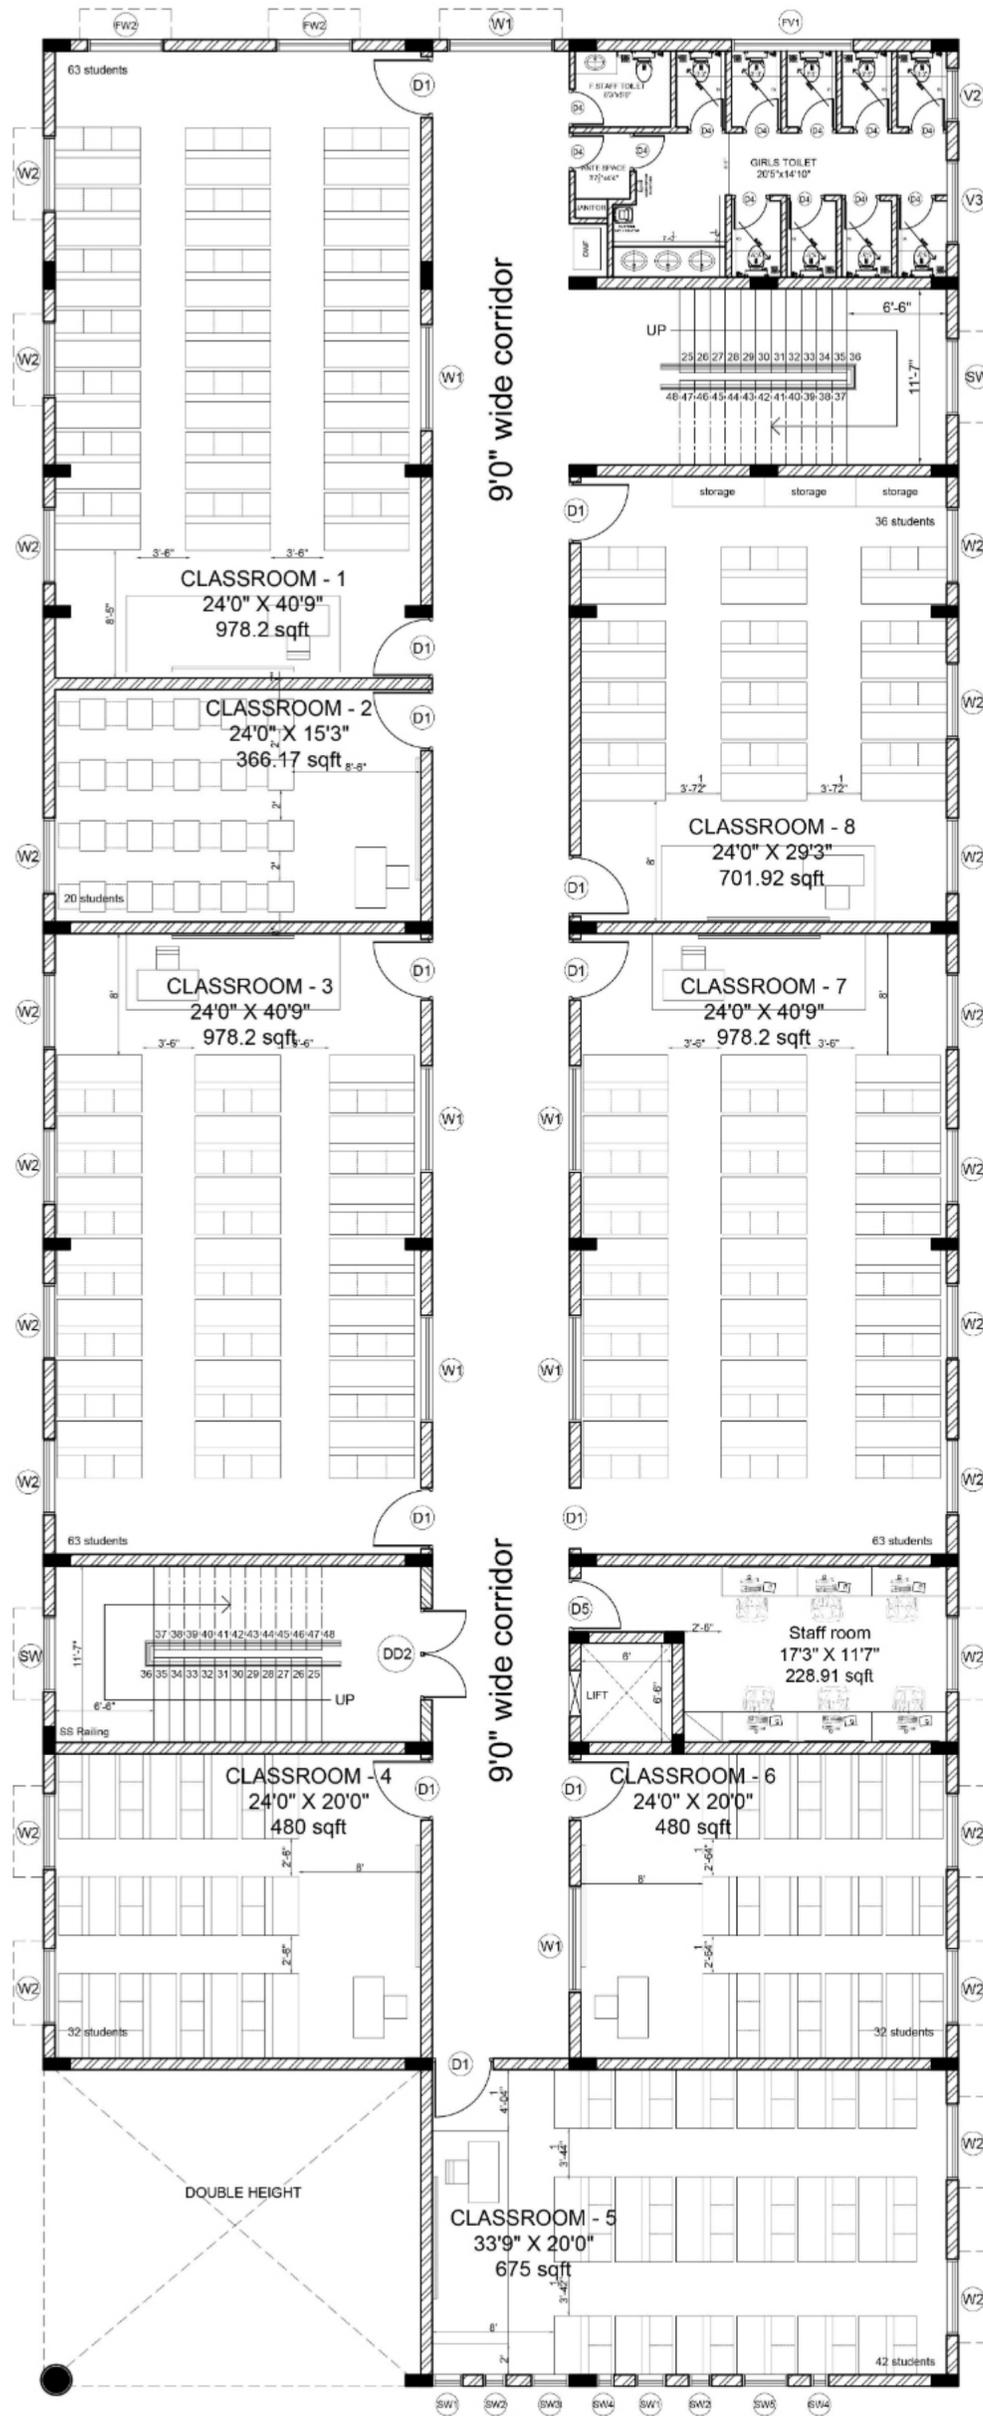

Tru
PRINCIPAL
 Hindustan College
 (A Unit of Hindustan Educational and Charitable Trust)
 No. 27/F, 3rd Stage, Rajarajeshwari Temple Road,
 J.P. Nagar, Mysore-570 008

Shu
SPECIAL OFFICER
 HINDUSTAN COLLEGE
 A UNIT OF HINDUSTAN EDUCATIONAL
 AND CHARITABLE TRUST
 No. 27/F, 3RD STAGE, INDUSTRIAL SUBURB,
 J.P. NAGAR, MYSORE-570 008

AS-BUILT
 DRAWINGS

Ramakrishnan D.
RAMAKRISHNAN D, M.Arch
 REGISTERED ARCHITECT
 No. CA/2005/35832
 Flat No: 5E, Ramaniyam PUSHKAR
 Phase 1, ECR Link Road,
 Sholinganallur, Chennai-600 119.

REASON OF ISSUE

ARCHITECTS


S7 STUDIO 7 ARCHITECTS
 PP-3, Janani Shrinilayam, Phase- 1,
 Semmencheri, OMR, Chennai- 600119

CLIENT
 HINDUSTAN GROUP

PROJECT
 HINDUSTAN COLLEGE, MYSORE

DRAWING TITLE	DRAWING CODE	REVISION
FIRST FLOOR PLAN	AR - 107	
SCALE 1:100	DRAWN BVASAN	R17
DATE 19-03-2025	CHECKED RAM	

*ALL DRAWINGS AND DIMENSIONS ARE IN FT

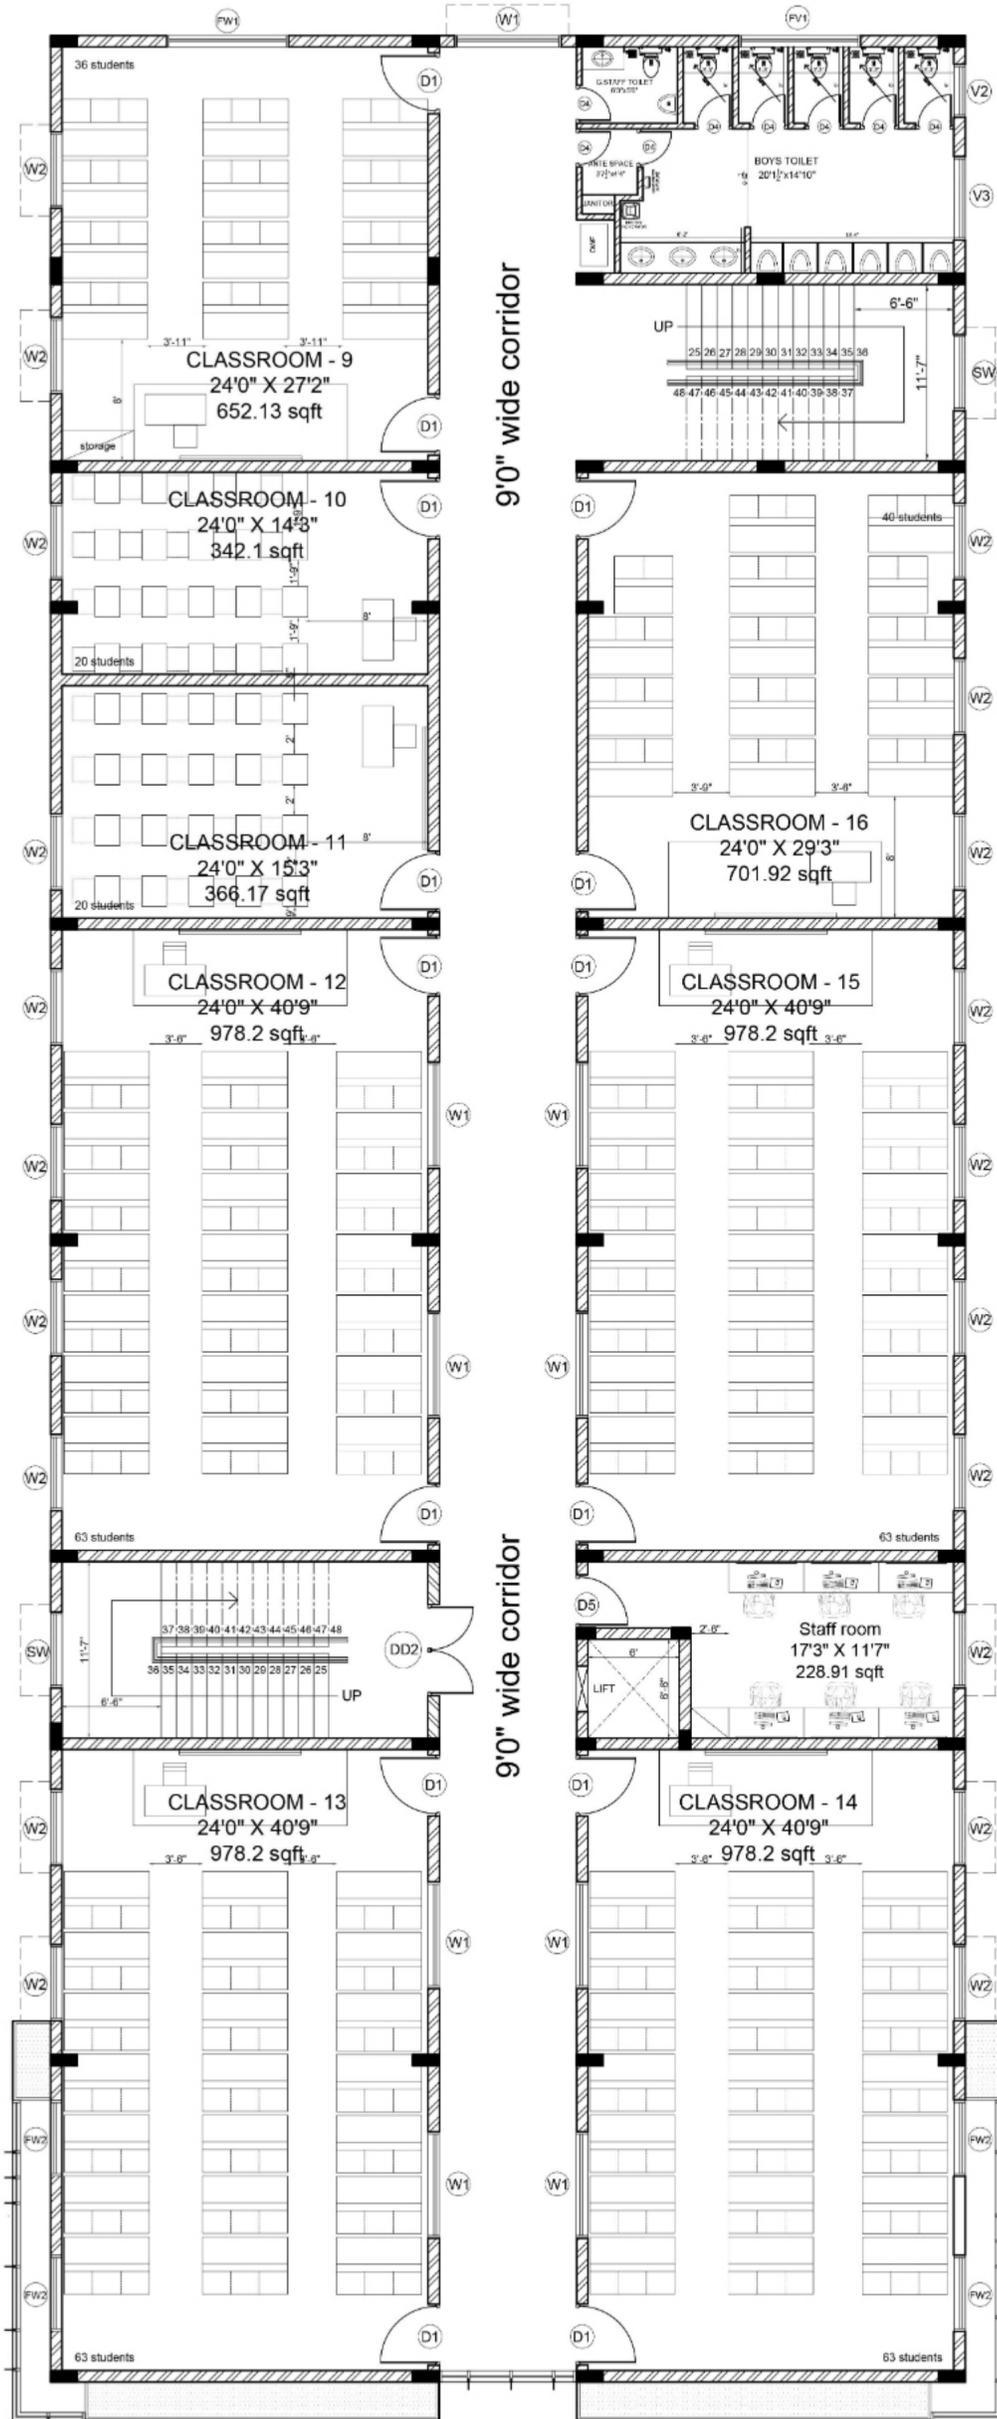

[Signature]
PRINCIPAL
 Hindustan College
 (A Unit of Hindustan Educational and Charitable Trust)
 No. 27/F, 3rd Stage, Rajarajeshwari Temple Road,
 JP Nagar, Mysore-570 008

[Signature]
SPECIAL OFFICER
 HINDUSTAN COLLEGE
 A UNIT OF HINDUSTAN EDUCATIONAL
 AND CHARITABLE TRUST
 No. 27/F, 3RD STAGE, INDUSTRIAL SUBURB,
 J.P. NAGAR, MYSORE-570 008

AS-BUILT
 DRAWINGS

[Signature]

RAMAKRISHNAN D, M.Arch
 REGISTERED ARCHITECT
 No. CA/2005/35832
 Flat No: 5E, Ramaniyam PUSHKAR
 Phase 1, ECR Link Road,
 Sholinganallur, Chennai-600 119.

REASON OF ISSUE

ARCHITECTS
 **STUDIO 7 ARCHITECTS**
 PP-3, Janani Shrinilayam, Phase- 1,
 Semmencheri, OMR, Chennai- 600119

CLIENT
 HINDUSTAN GROUP

PROJECT
 HINDUSTAN COLLEGE, MYSORE

DRAWING TITLE	DRAWING CODE	REVISION
SECOND FLOOR PLAN	AR - 108	
SCALE 1:100	DRAWN BVASAN	R17
DATE 19-03-2025	CHECKED RAM	